

April 1, 2024

Via Email/Original by Mail

Address
Address
Address
Address

Dear Interested Party:

Re: Many Island Pipe Lines (Canada) Limited (MIPL) Pierceland Supply Variance Application for the Cold Lake – Beacon Hill Decommissioning Project

Please find enclosed for service on you a Variance Application pursuant to Section 69 of the *Canadian Energy Regulator Act* [link].

The purpose of the variance is to address approximately 30 metres of MIPL pipeline within the CLBH #1 facility yard site located at SW-12-62-01-W4M, Municipal District of Bonnyville No. 87, Alberta (the Pipeline Segment). This Pipeline Segment predates the Pierceland Supply construction, is not required for the operation of the final installation, and its removal will not impact service under any circumstance. No outage is required to perform the work.

Potentially affected persons and communities may contact the Canada Energy Regulator (CER) at any point before the CER Commission makes its decision. As part of our commitment to ensure organizational preparedness and resilience, and to meet regulatory requirements of the CER, we are seeking feedback. If you wish to have information considered, or have concerns or require more information, we encourage you to let MIPL know by email within fourteen days of this letter.


We also enclose a letter from the CER CEO with respect to the Canada Energy Regulator Approach to Crown Consultation.

Information on MIPL's engagement and land complaint processes can be found on the MIPL's website at: <https://www.miplcl.com/projects>. CER brochures and publications of interest, including information on the CER are available here: <https://www.cer-rec.gc.ca/prtcptn/gdnccmpnsnbpblctn-eng.html>.

All application materials to date on the Pierceland Supply Project can be seen at: <https://apps.cer-rec.gc.ca/REGDOCS/Item/View/3781663> (or go to the CER website at <http://www.cer-rec.gc.ca/> click on "Applications & Filings" under the heading "View Regulatory Documents, enter the Document Number A99944 and click on "Go".)

Should you wish to contact the CER, please reference file number File OF-Fac-Gas-M182-2019-02 01, [Many Islands Pipe Lines \(Canada\) Limited - Pierceland Supply Project](#). CER's preferred method is online through its e-filing tool which provides step-by-step instructions. If unable to file a document online, it may be filed by email to Secretary@cer-rec.gc.ca. Please copy tjordan@saskenergy.com.


We look forward to your response and hope that you will provide any questions or concerns regarding this important initiative.

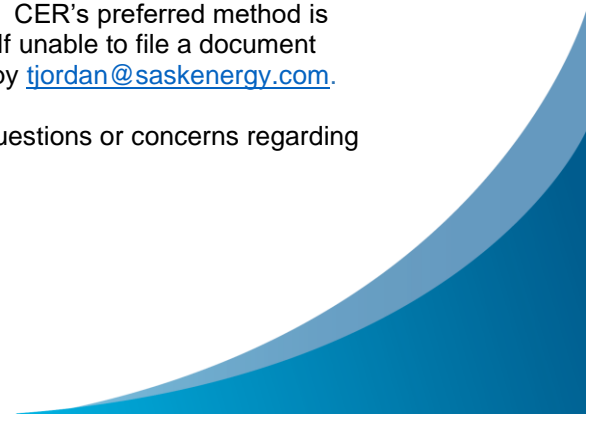



If you have any questions or comments, please contact the project team at (306) 570-1546 or email manyislands@saskenergy.com. Thank you.

Sincerely,



Wade Goodwin
Land & Public Awareness Coordinator

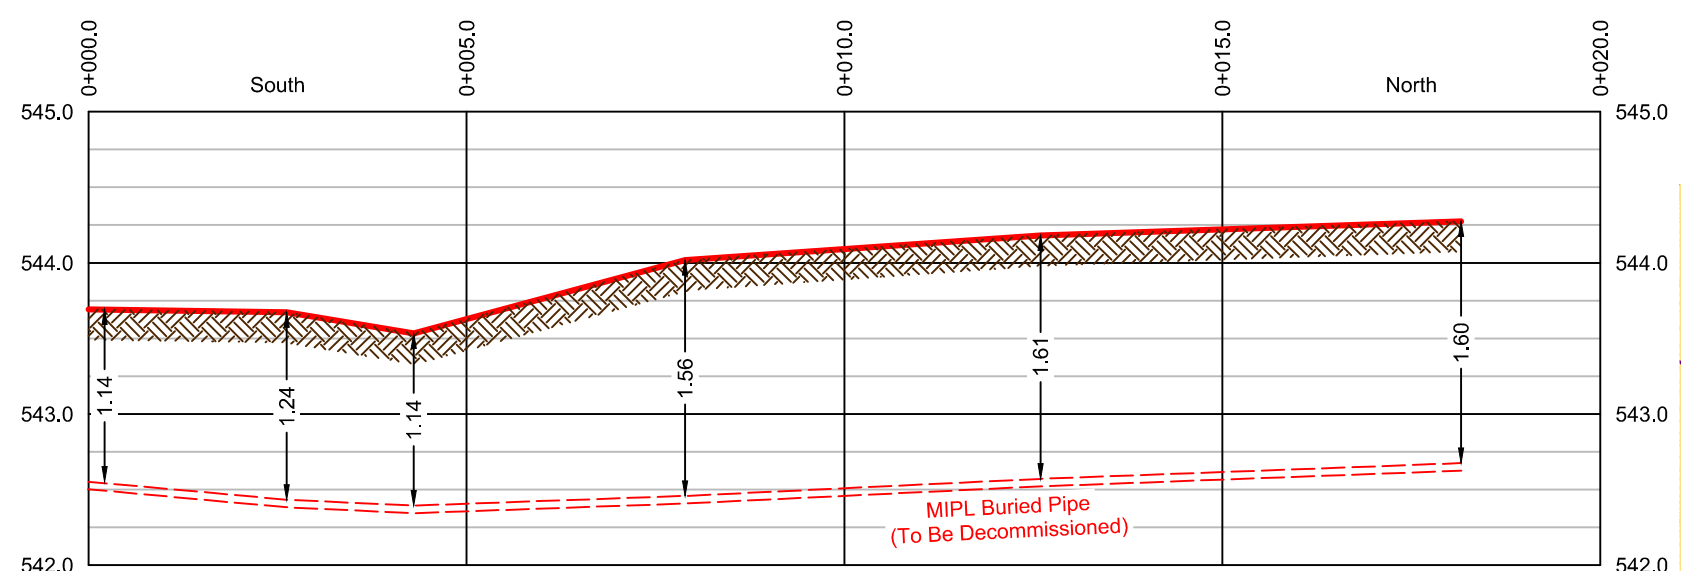


Profile Along MIPL Buried Pipe (To Be Decommissioned)
Scales - 1 : 100 Horiz. 1 : 50 Vert.

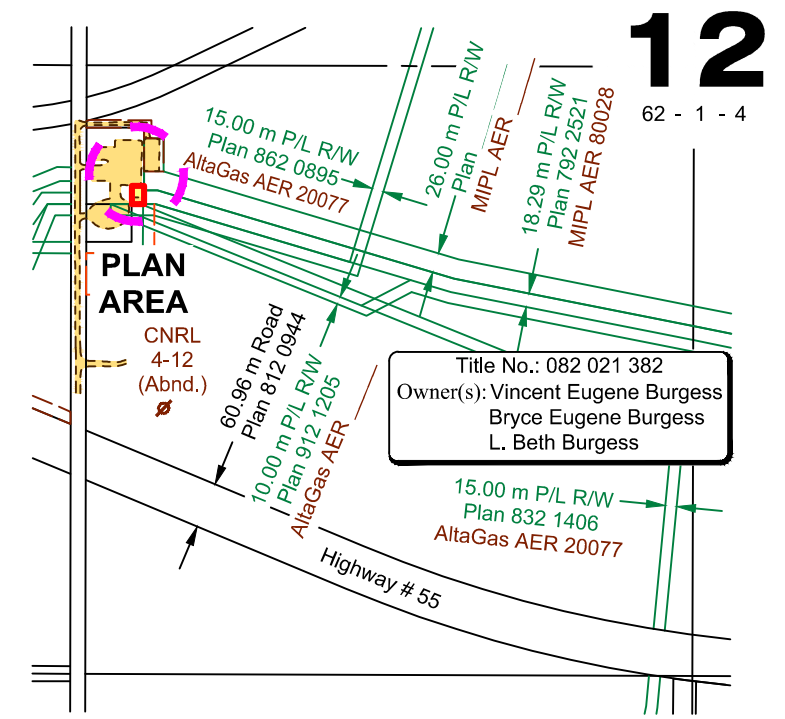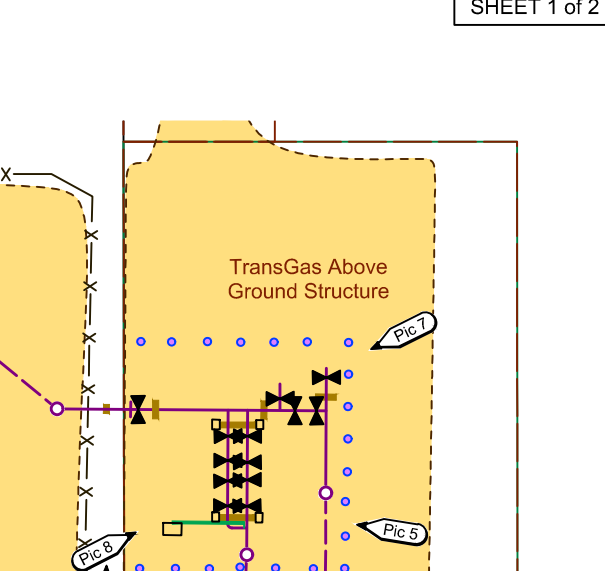

LOCATION PLAN
Scale - 1 : 10,000

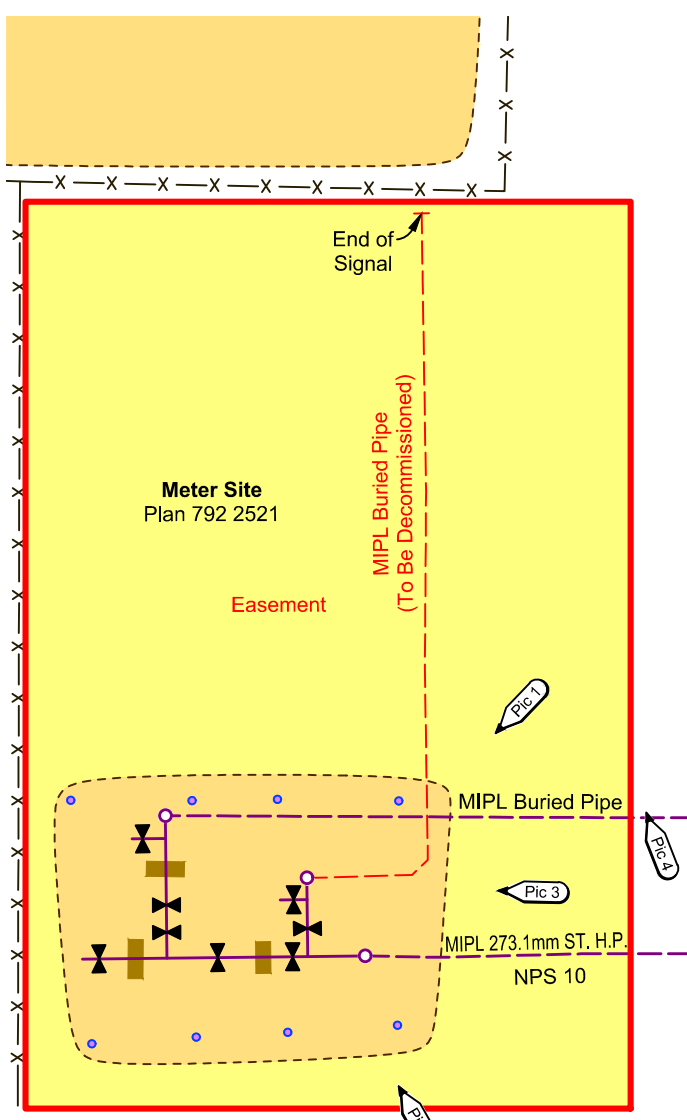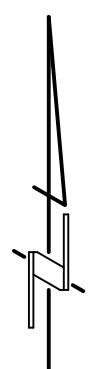

DETAIL
Scale - 1 : 200

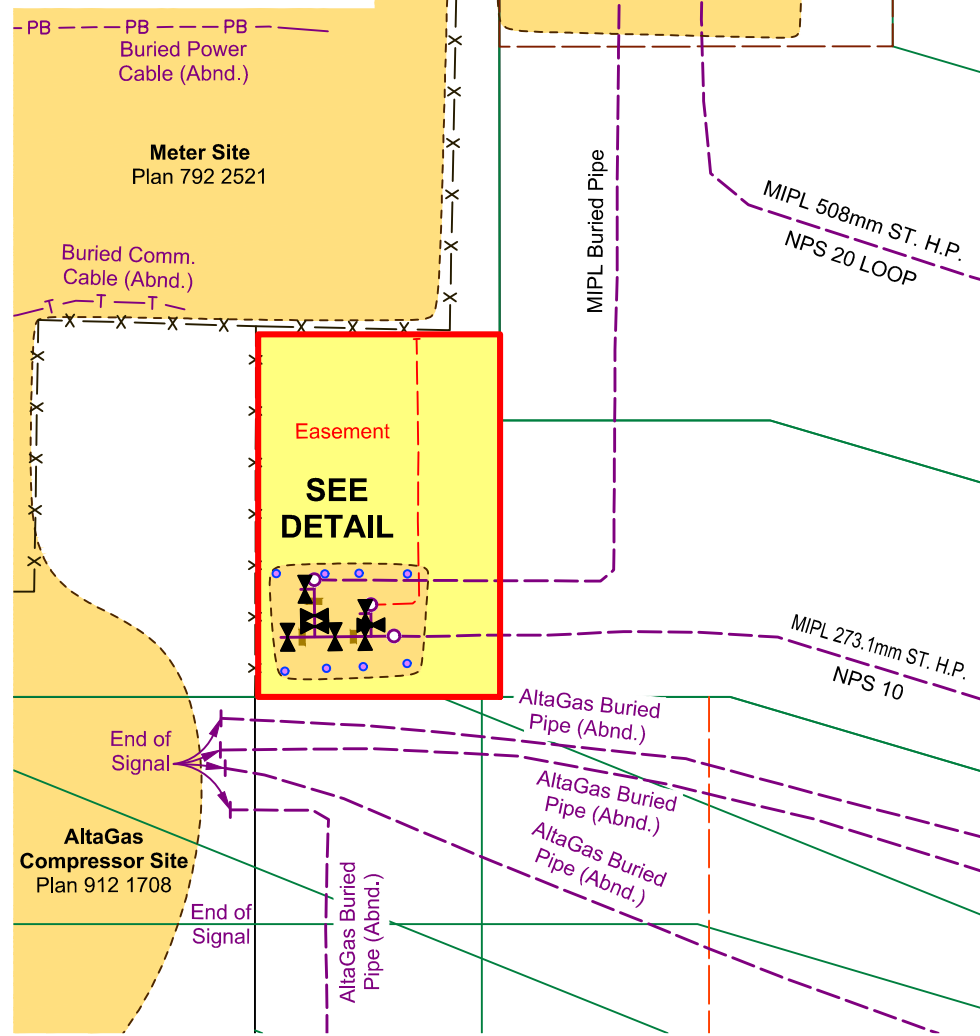

- LEGEND**
- Riser shown thus
 - Valve shown thus
 - Buried Pipeline shown thus
 - Above Ground Pipeline shown thus
 - Fence shown thus


 As-Built Plan of
CLBH #1 NPS10 Decommission
Cold Lake - Beacon Hill
 in
S.W.1/4 - Sec.12 - Twp.62 - Rge.1 - W.4M.
Municipal District of Bonnyville No. 87
Alberta

Scale - 1 : 500

NO.	REVISION	BY	DATE
3.	Amended MIPL Buried Pipe and Added Easement	SK - RM	Nov. 6, 2023
2.	Amended R/W Label	SD - RM	June 20, 2023
1.	Amended Logo	SD - RM	June 20, 2023

JCN No.: 202291002 File: 23-02207-001-AB-R3
 Survey Date: June 8, 2023 Job No.: 23-02207-001



Pic 1



Pic 2



Pic 3



Pic 4



Pic 5



Pic 6



Pic 7



Pic 8



Pic 9